

ACCESS OF EXISTING
CARPARK UNTIL NEW
ENTRY OFF AUBURN
GAINED.



$7.5 = 5 = 0.66$

NOTED HEADLINE
 INTERMEDIATE
 & CHAIR RACING
 25X5M
 (NTS)

TO DO
 SURVEY
 AREA


PAIDORNE

PAIDORNE

PAIDORNE

UPGRADED

PAIDORNE AVE
 ACCESS

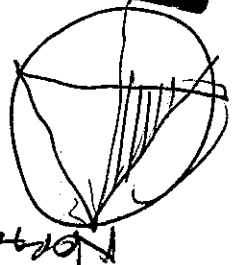

NEW GYM

ABUTMENTS

PAVED PLAYING


CARPAGES

EXISTING CLASSROOMS

NEW DENTAL FACILITY

covered area

CEOTNEY AREA

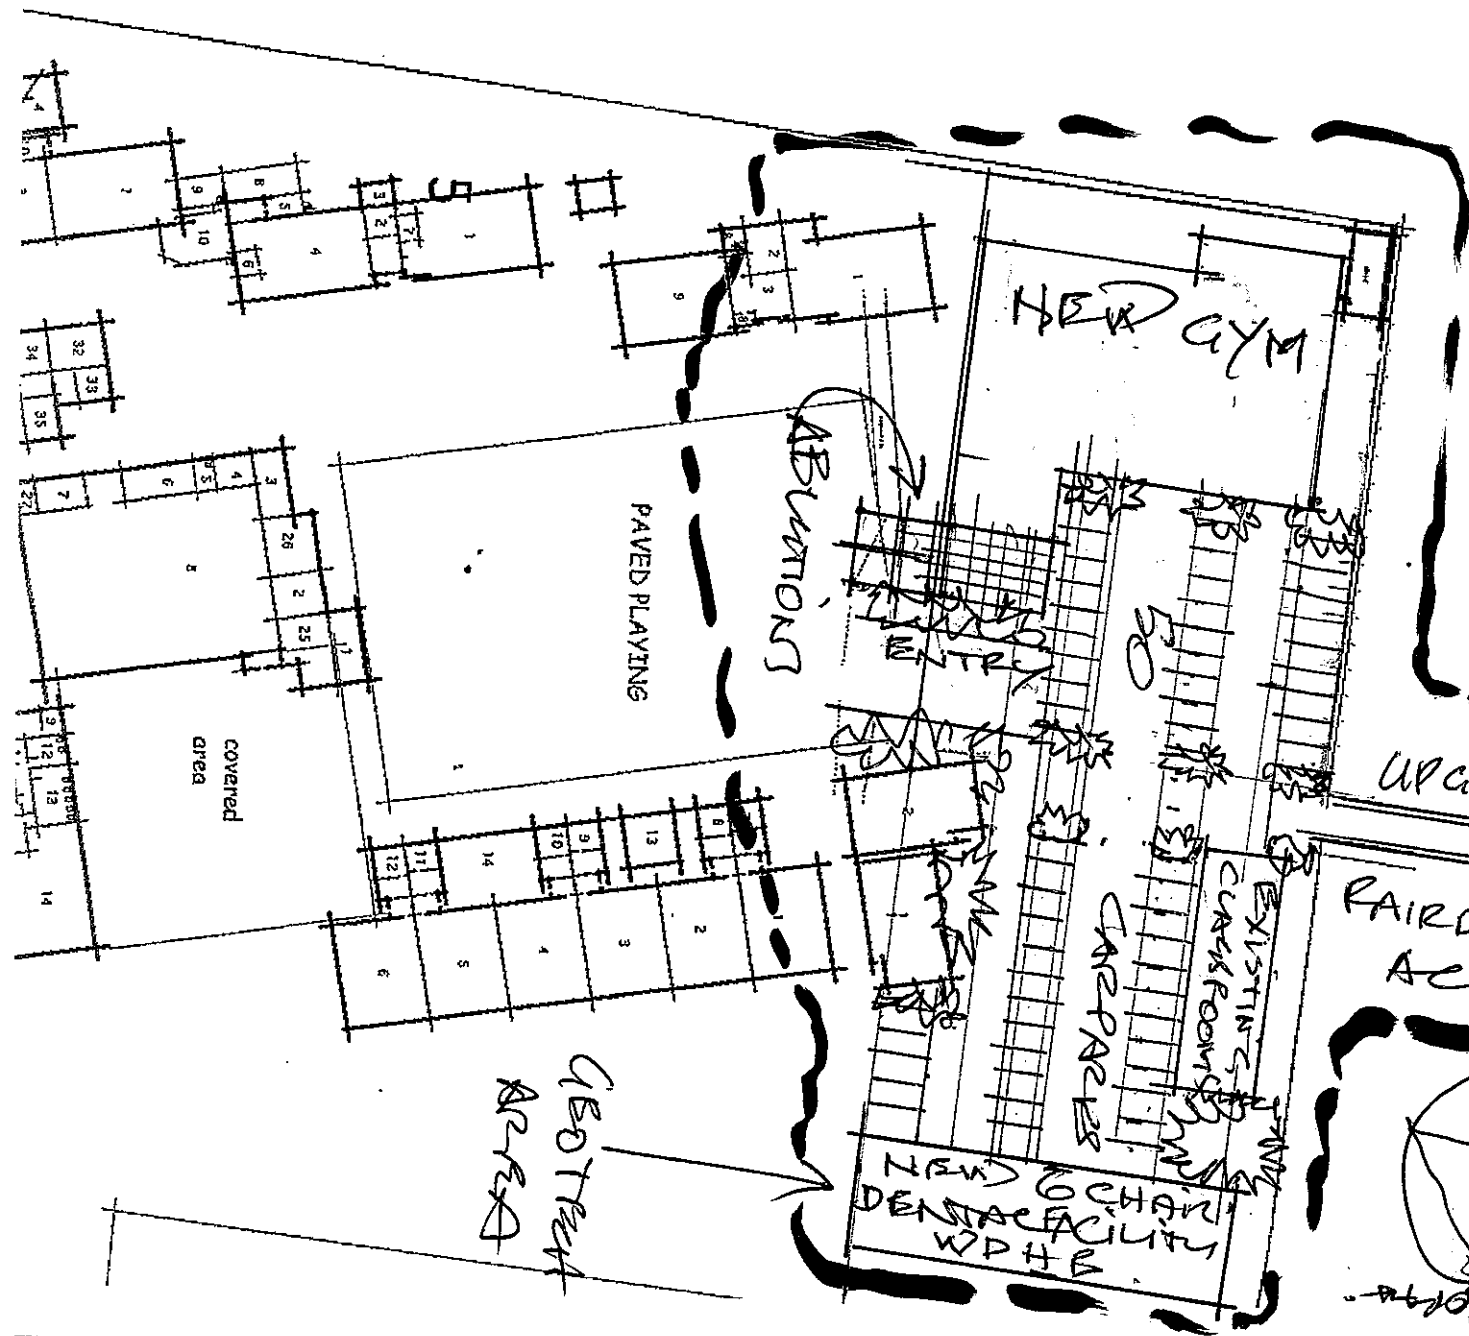

GROTECA 2 CHAIN FACILITY
AND SMALL CARPARK 18M x 9M

EXISTING CROSSOVER
RB-USRD.

NEW 2 CHAIN FACILITY
NEW HALL (BUILT)


EDMONTON School
NDHS PROPOSED NEW
DENTAL FACILITIES
Rd HARVEY
21/7/03
(NTS)

KEY:

- SP 1 Approximate Sca penetrometer Test Locations, Soil and Rock Consultants, 6 June 2001
- ⊕ AH 1 Approximate Augerhole Locations, Soil and Rock Consultants, 6 June 2001

NOTES:

1. Locations of features approximate only.
2. Location of all buried services to be verified prior to construction
3. Original sheet size A3

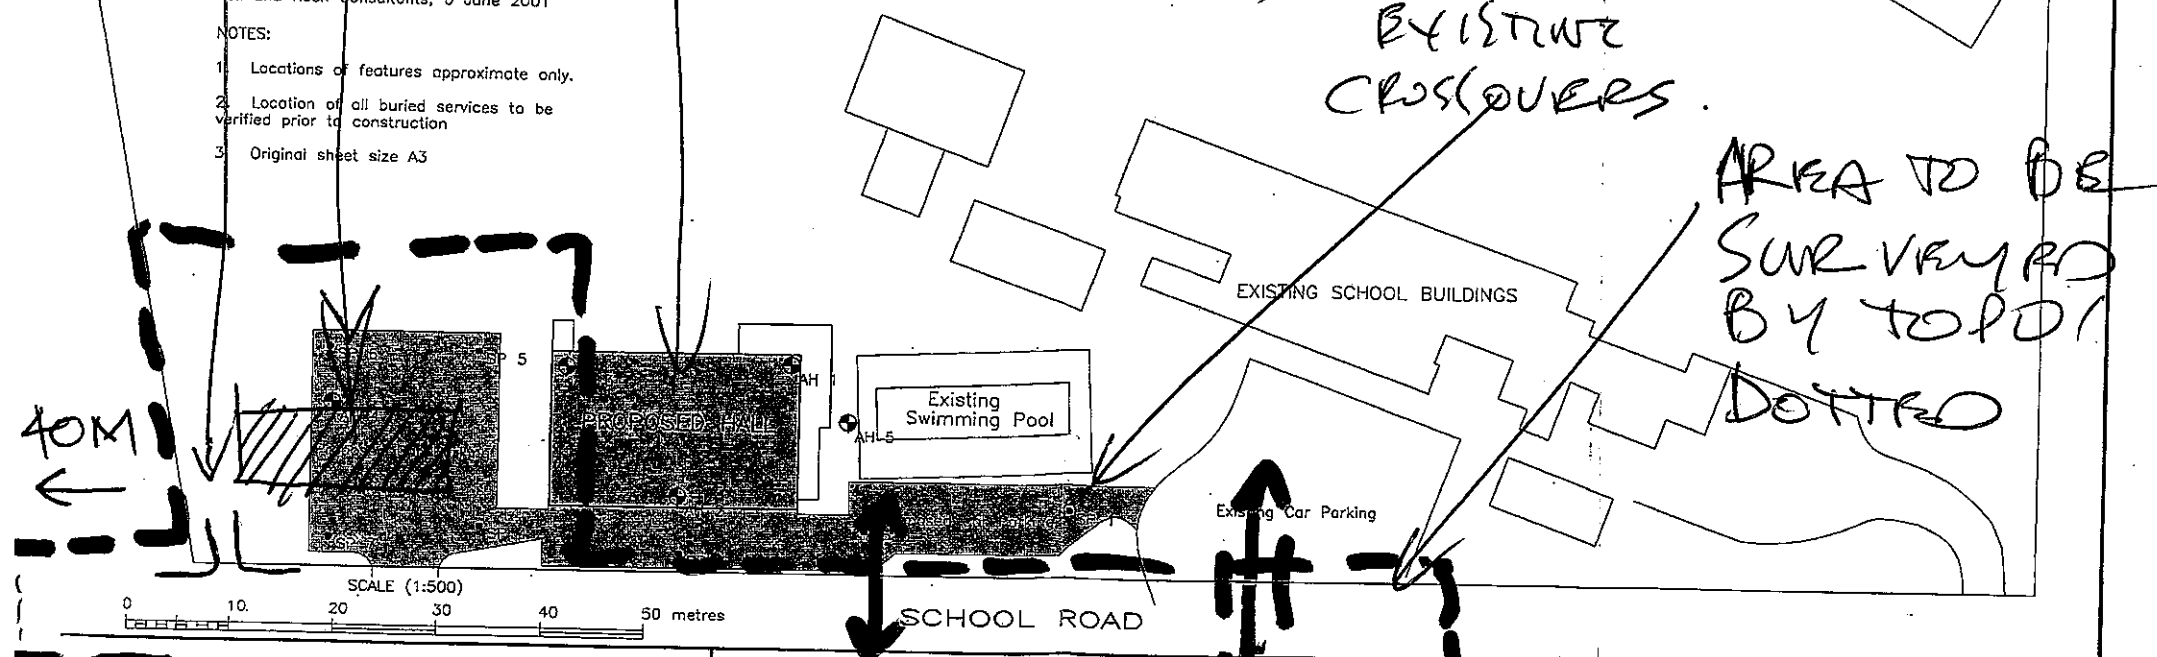

SOIL & ROCK CONSULTANTS

Consulting Geotechnical Engineers

SITE PLAN

PROPOSED HALL AT
EDMONTON PRIMARY SCHOOL, TE ATATU SOUTH

SCALES: 1: 500

DATE: 8 June 2001

DRAWN: RKH

CHECKED: S&RC

DRAWING NO:

01171/1

SHEET 1 OF 1

WDHB - PROPOSED NEW
DENTAL FACILITY
20 HARVEY 21/7/09.
TO WOODS & COFFRY.
(NTS)

2 CLASS ROOMS TO BE
REMOVED IN HATCHED
AREA AND REPLACED WITH *

GROUNDER UNDER
THIS FOOTPRINT
PLEASE CHECK.


*
NEW 4 CHAIR FACILITY
OR 28 M X 9 M
ACCESS TO FRONT

Site Plan

TO DO
Survey
AREA IN
DOTTED

TRY TO
INCREASE
CAR PARKING
BY 4 CARS
+ 2

SURVEY
ROAD

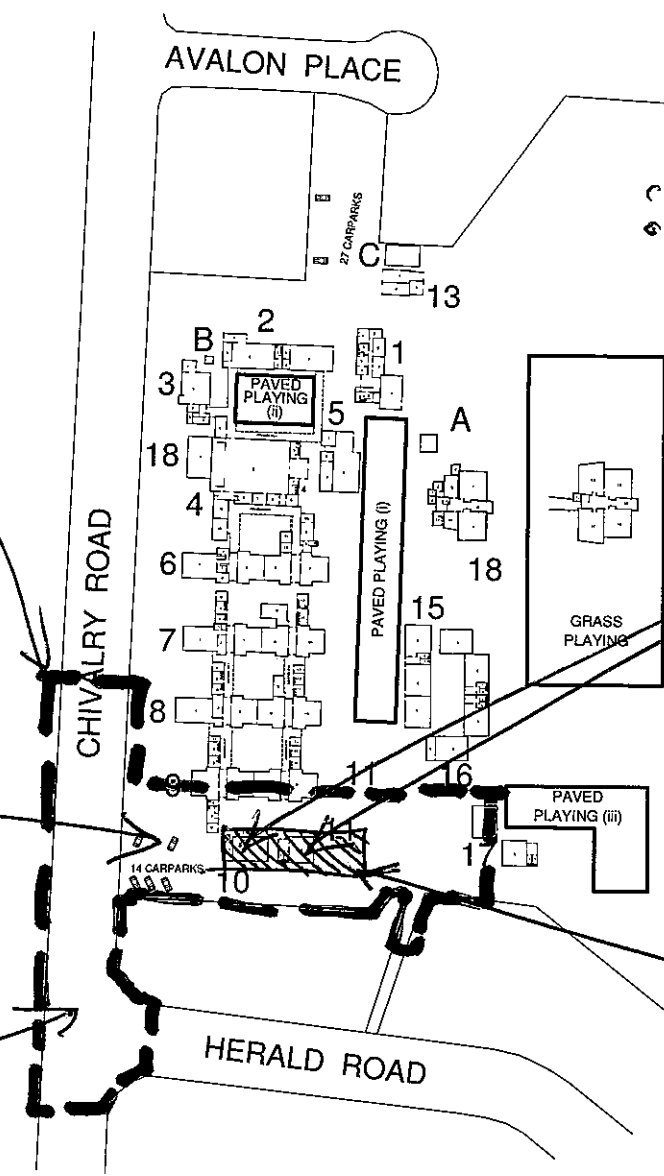

Ph/fax: 473 3321, Mob: 021 02711589
e-mail: michelle@asbuiltplans.co.nz

EXISTING SITE PLAN
at Glenfield Intermediate School
for Ministry of Education

Glenfield Intermediate School

1

DRAWN Michelle Haywood
DATE March 2008

SCALE 1:1500 - A3

SHEET 1 OF 1
JOB #