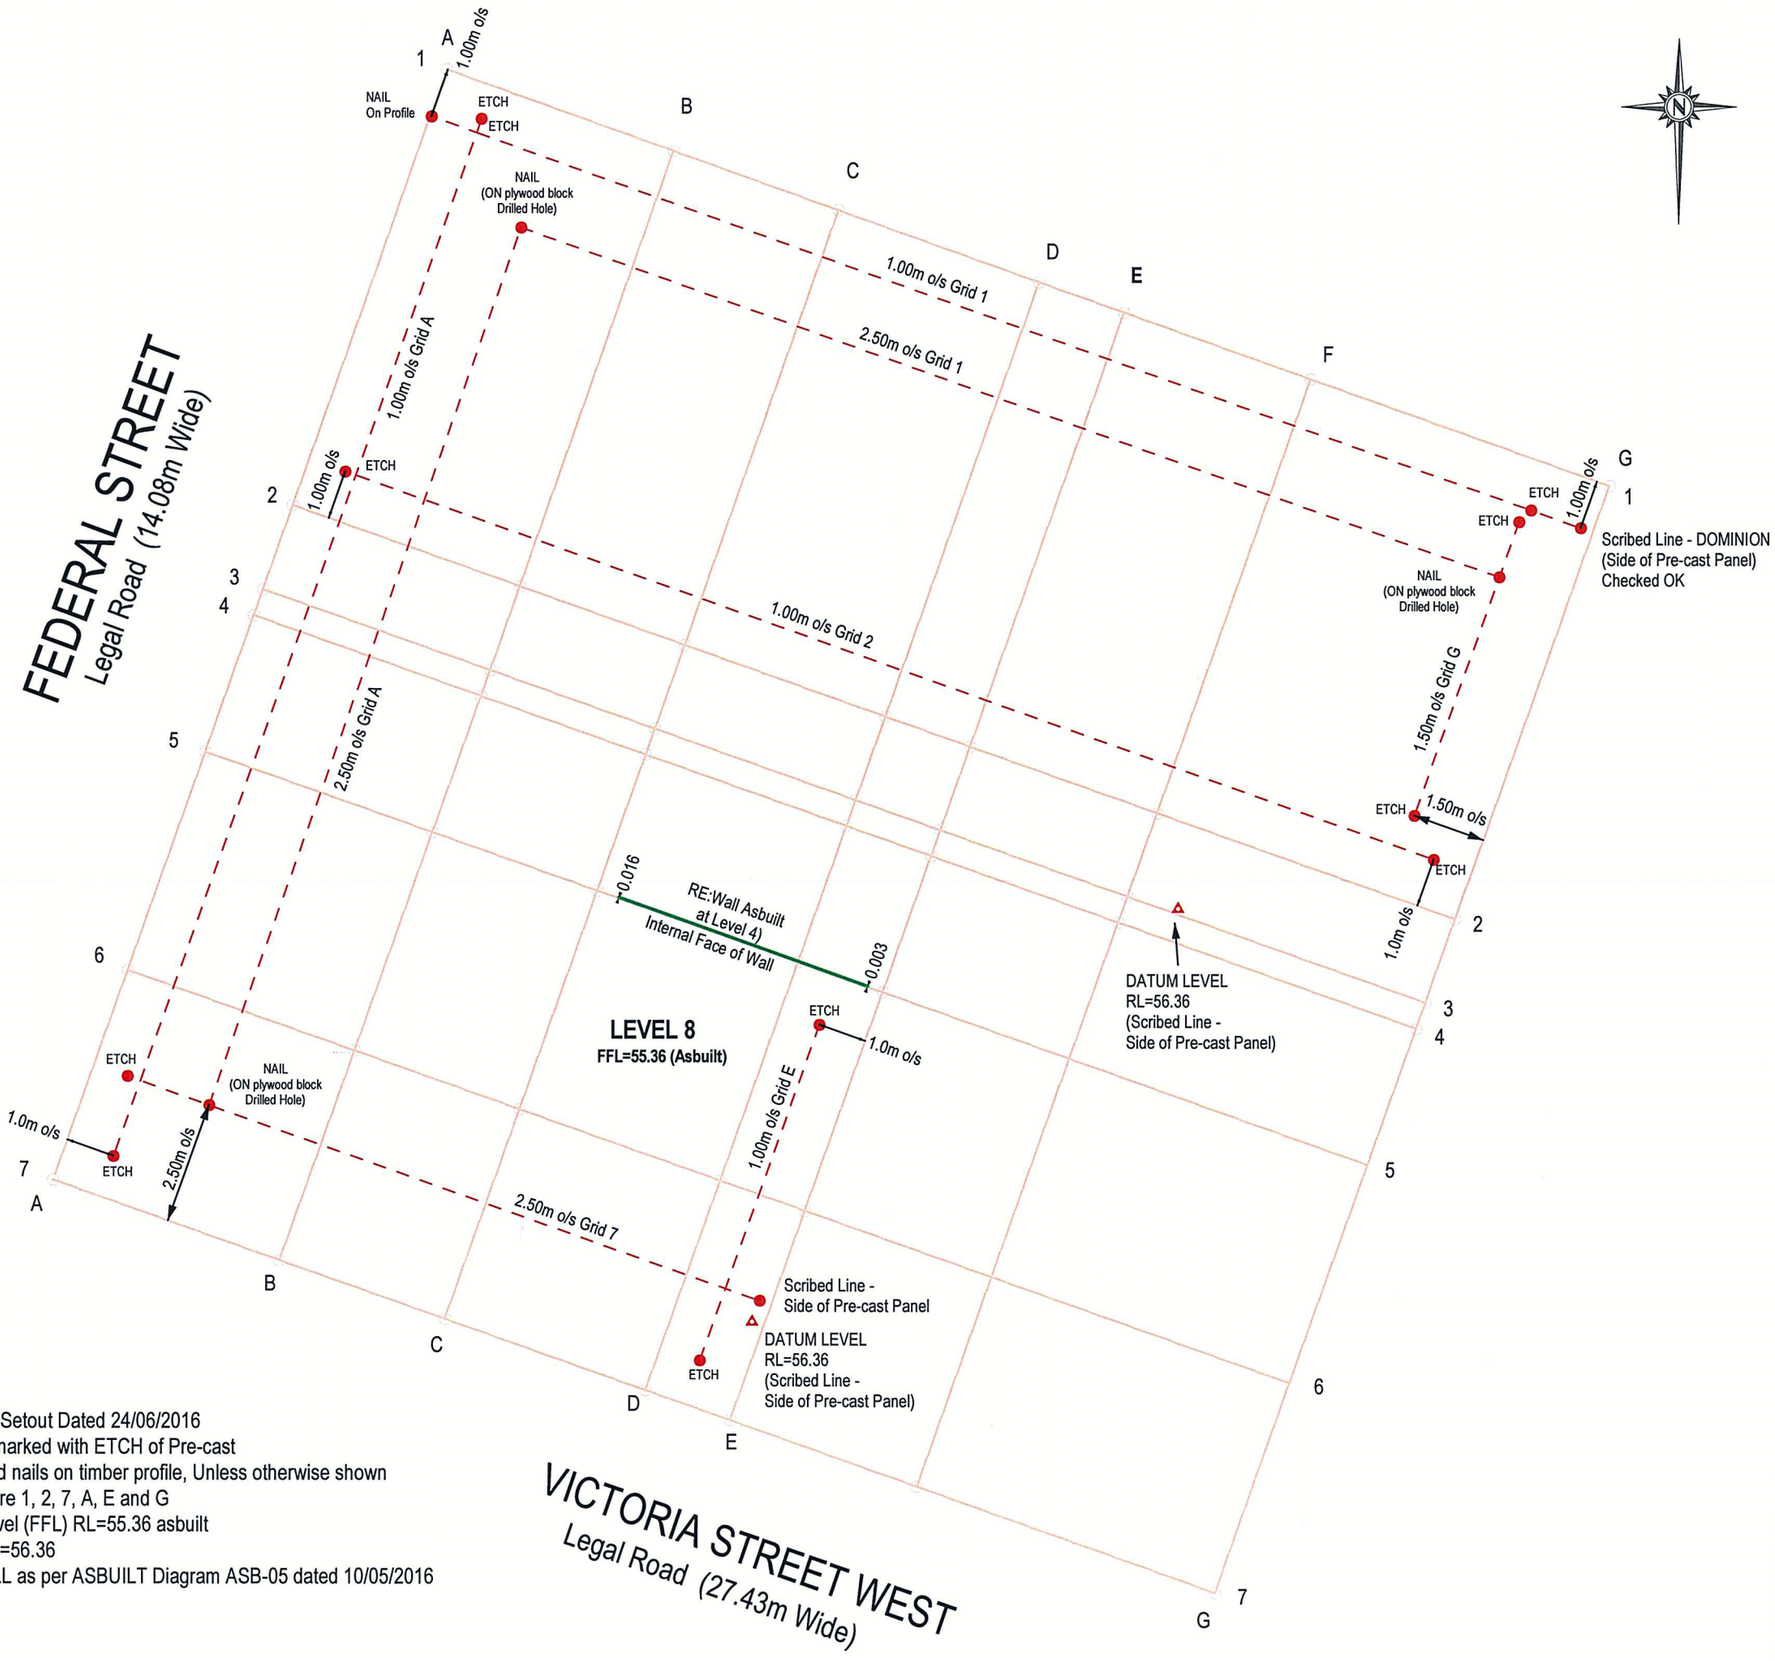

NOTES
1. LEVEL 8 Gridline Setout Dated 24/06/2016
2. All Setout points marked with ETCH of Pre-cast Panel and Walls, and nails on timber profile, Unless otherwise shown
3. Gridlines Setout are 1, 2, 7, A, E and G
4. Finished Floor Level (FFL) RL=55.36 asbuilt
5. Datum Levels RL=56.36
6. Re-asbuilt of WALL as per ASBUILT Diagram ASB-05 dated 10/05/2016

SURVEYED	AJF	24/06/2016
DESIGNED		
DRAWN	AJF	27/06//2016
TRACED		
CHECKED		

APPROVED EH DATE 27/06/16

REVISION	CHANGES	CHECKED	DATE

NOTES

1. COORDINATES IN TERMS OF GEODETIC DATUM 2000 ORIGIN: SS42 SO 48167 803505.36mN 399858.15mE

2. LEVELS ARE IN TERMS OF AUCKLAND VERTICAL DATUM (MSL) 1946 ORIGIN: SS42 SO 48167 RL=29.06

3. ALL SETOUT POINTS BASED ON THE OFFSET MEASUREMENTS TO GRIDLINE AS INSTRUCTED BY CONTRACTOR ON SITE

CLIENT
DOMINION

PROJECT
75 VICTORIA STREET WEST
AUCKLAND

TITLE
DIAGRAM OF GRIDLINES SETOUT POINTS AND DATUM LEVELS LEVEL 8

Barry Satchell
- CONSULTING ENGINEERS
- RESOURCE MANAGERS
- ENVIRONMENTAL CONSULTANTS
- SURVEYORS & PLANNERS

409 DOMINION ROAD, BALMORAL
PO BOX 10-343
DOMINION ROAD
AUCKLAND
TEL:+64-9-623-4573
FAX:+64-9-639-0845
WEB:www.bscl.co.nz

The copyright of this design and drawing is vested in Barry Satchell Consultants Ltd, unless otherwise indicated.

SCALE 1:125 (A3)

JOB FILE No. P:\7040\Survey\Civilcad\7040 Setout.mjo - SO15

JOB No	SHEET No	REVISION
7040	SO15 SHEET 1 of 1	0